

**SUITE
 V/W**


PLAZA DEL
 SOL CENTER

PROPERTY
 CLIENT
 SERVICES

3-8-18

AS-BUILT
 PLAN

AS.1

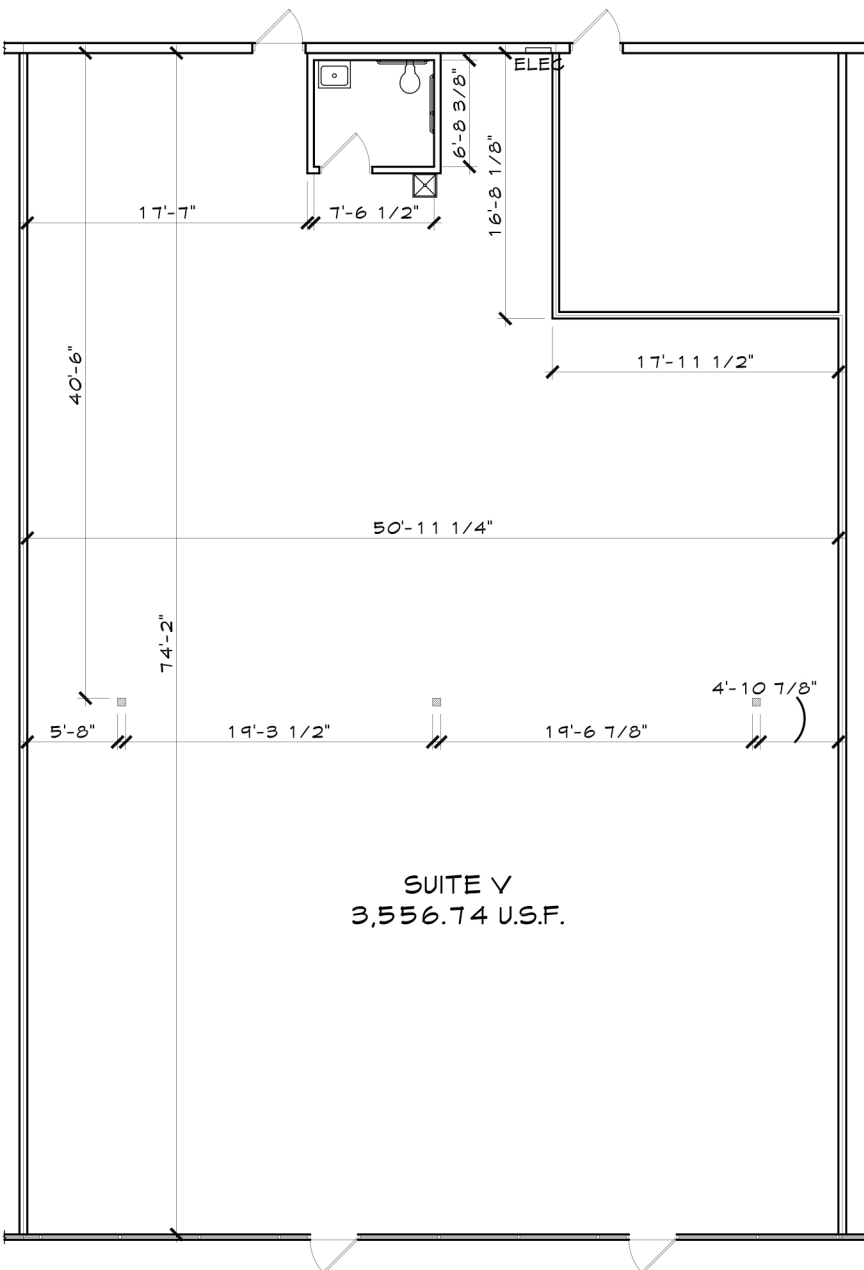

A FLOOR PLAN

SCALE: N.T.S.



NORTH