



ARCHITECTURE \ INTERIORS \ ENGINEERING

KKT ARCHITECTS, INC.

2200 SOUTH UTICA PLACE, SUITE 200

TULSA, OKLAHOMA 74114

[P] 918.744.4270 \ [F] 918.744.7849

WWW.KKTARCHITECTS.COM

C O F A # 534 6 / 30 / 19

SUITE 420

PARK
TOWER
4TH FLOOR


CASE &
ASSOCIATES

04.19.18



AS-BUILT
PLAN

AS.420

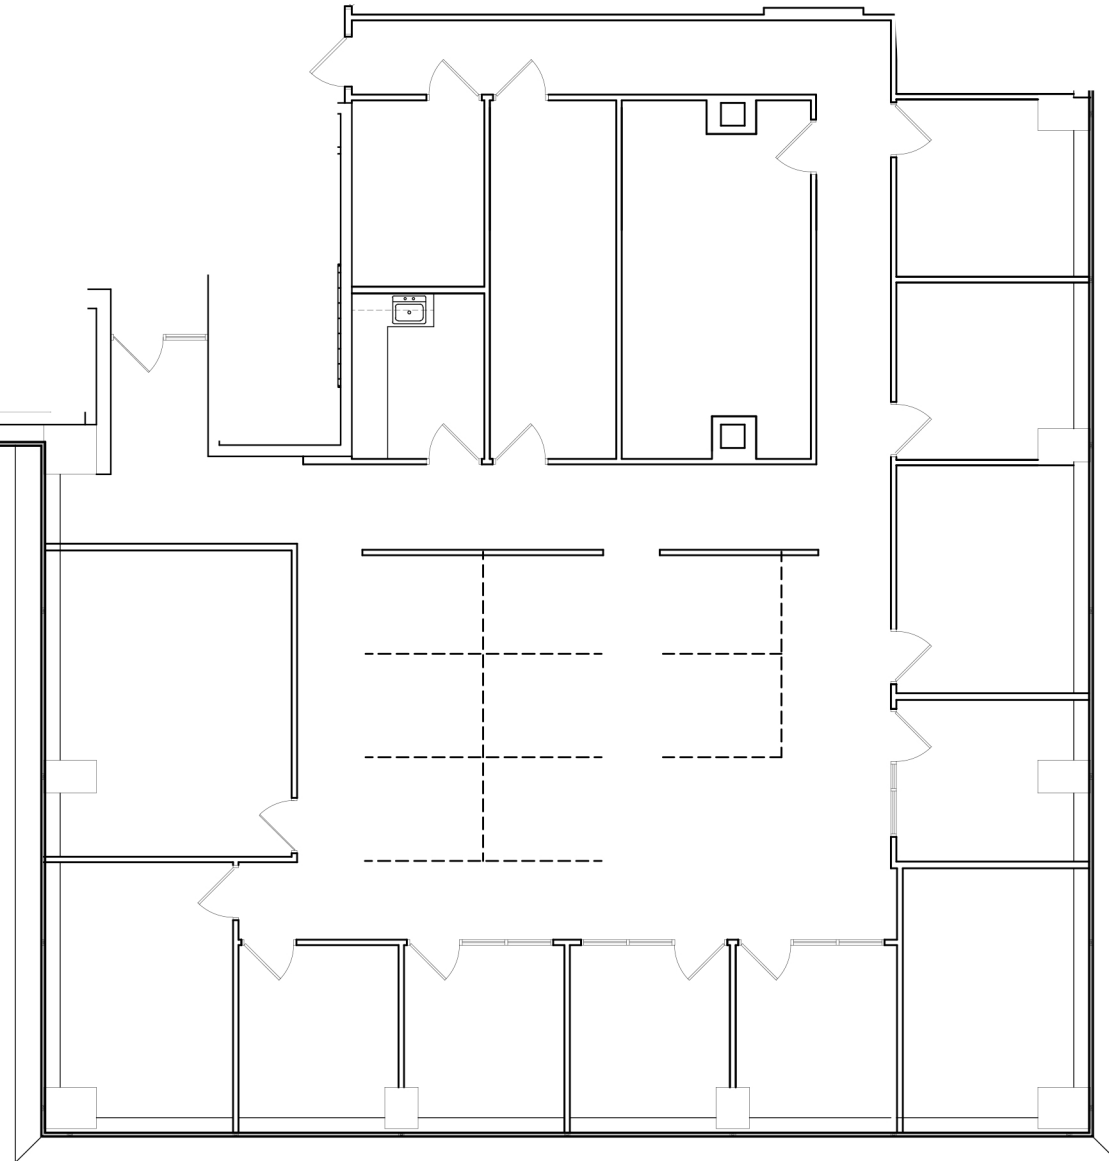


A FLOOR PLAN

SCALE: N.T.S.



NORTH

SUITE 420
VACANT
4,317 RSF

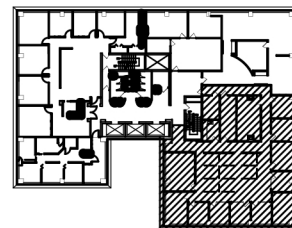

KEY PLAN