




Kinslow, Keith & Todd, Inc.
 architecture | interiors
 tel 918.744.4270
 fax 918.744.7849
 2021 south lewis suite 150
 tulsa, oklahoma 74104
 www.kktarchitects.com
 info@kktarchitects.com

**SUITE
303**

SOUTHEAST TECH
 CENTER
 5411 S 125TH E AVE
 BUILDING C

CASE
 & ASSOCIATES

SCALE	AS NOTED
FILE NAME	SFCAS
MANAGER	ELS
DRAWN BY	ELS
04.08.15	

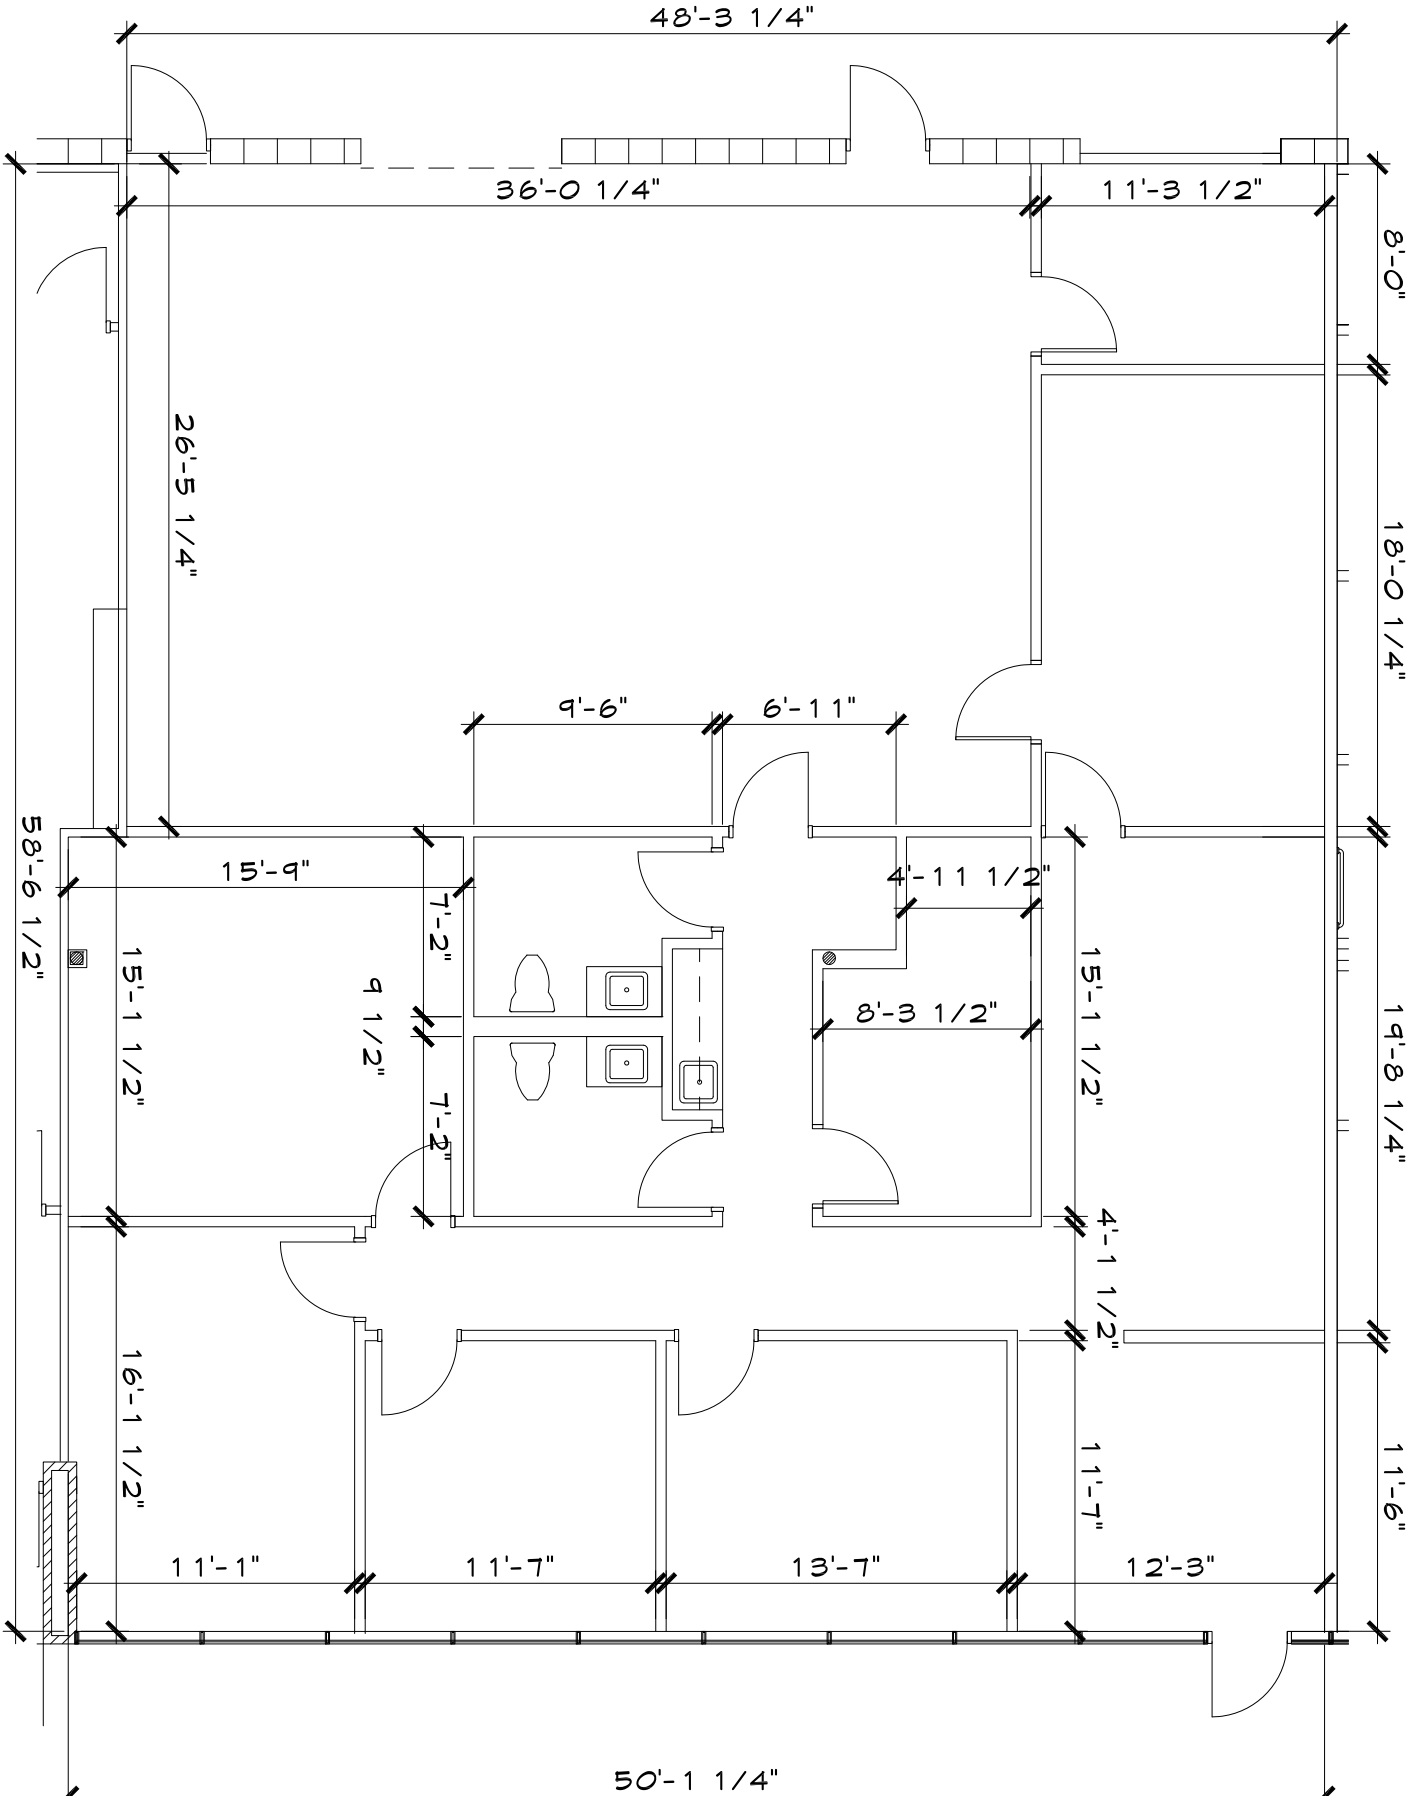

A FLOOR PLAN

SCALE: 1/8"=1'-0"



AS-BUILT
 PLAN
AS.1