




Kinslow, Keith & Todd, Inc.
 architecture | interiors | engineering
 tel 918.744.4270
 fax 918.744.7849
 2200 south ulfca place, suite 200
 tulsa, oklahoma 74114
 www.kktarchitects.com

TOTAL BUILDING
 11349.10 SF

SUITE 202
 SCHOLASTIC SALES,
 INC. (JOSTENS)
 674 RSF

SUITE 204/220
 GREEN TEAM
 AGENCY ALLSTATE
 1261 RSF

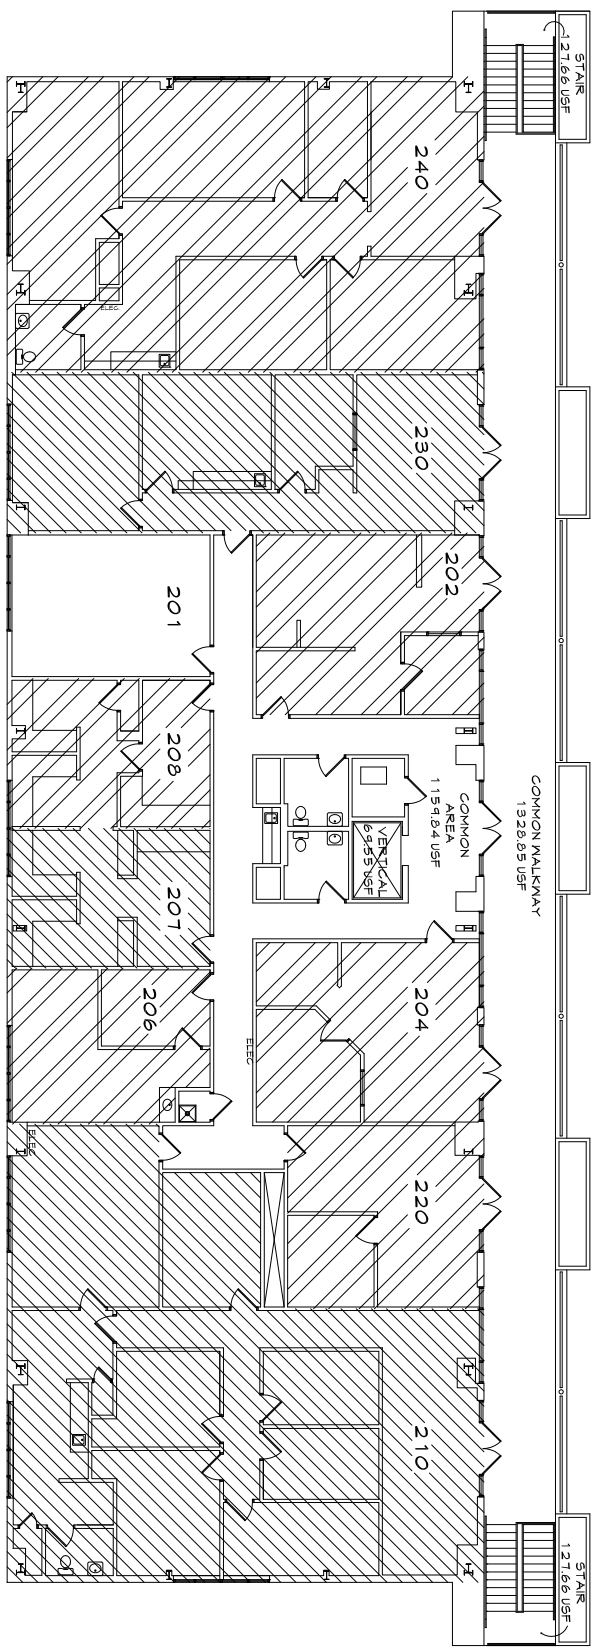

SUITE 240
 WHITNEY MFG. CO.
 2293 RSF

SUITE 230
 SCOTT
 CAMPBELL CPA
 1245 RSF

SUITE 201
 VACANT
 481 RSF

SUITE 208
 MICHAEL
 STEPHENS
 481 RSF

SUITE 207
 JUSTIN
 JOHNSON
 481 RSF

SUITE 206
 QES, LLC
 494 RSF

SUITE 210
 BLACK FOREST
 DECOR
 2804 RSF

329 SOUTH
 ELM STREET
 JENKS, OK
 2ND FLOOR

ELM STREET
 MARKET

SCALE	FILE NAME	N.T.S.
MANAGER	YW	
DRAWN BY	CH	
	EIS	
07.31.14		

A FLOOR PLAN

SCALE: N.T.S.

NORTH

AS-BUILT
 PLAN
 AS-1